


proposed exterior partition detail  
3" = 1'0"



as-built exterior partition detail  
3" = 1'0"



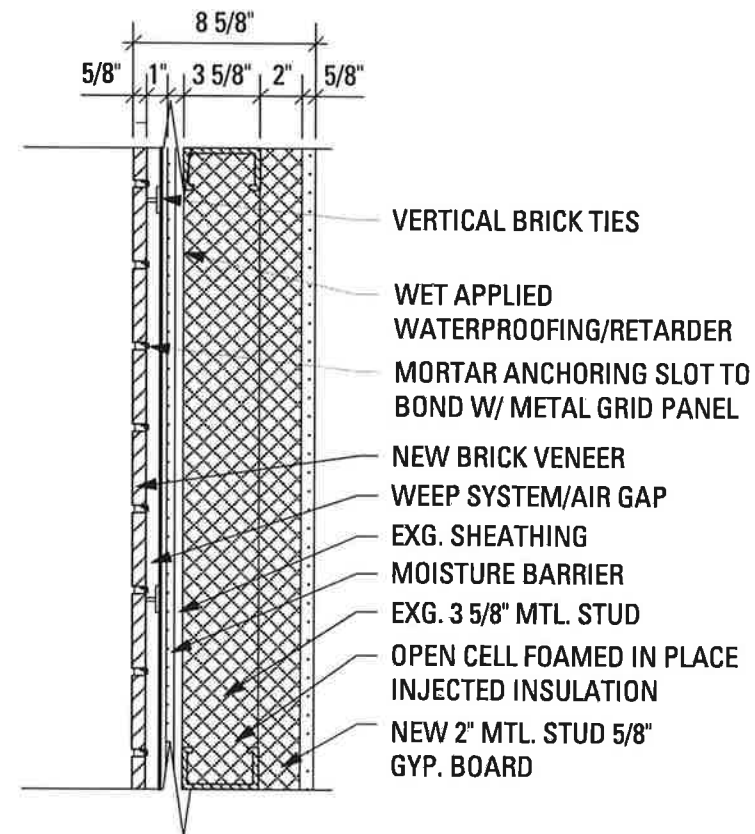

47W 8th Street - site photos

10/15/2015 scale: NTS





47W 8th Street - site photos

10/15/2015

**MESH**





existing conditions circa 2009  
view from W 8th Street



existing conditions circa 2012  
view from W 8th Street



proposed new façade  
view from W 8th Street